

South Carolina Department of Health and Environmental Control  
Office of Ocean and Coastal Resource Management  
1362 McMillan Avenue, Suite 400  
Charleston, South Carolina 29405

**February 5, 2014**  
**Permit Application Public Notice**

***Margaret Wannamaker, OCRM-14-024-B***

The Department has received an application for a permit for the alteration of a critical area. The application was submitted pursuant to the Coastal Zone Management Act (Act 123) of 1977 South Carolina General Assembly. The application in brief, is described as follows:


**LOCATION:** On and adjacent to Toomer Creek at 3802 Adrian Way, Park West, Mount Pleasant, Charleston County, South Carolina.  
TMS: 594-12-00-227.

**WORK:** The work as proposed is for after-the-fact authorization at a dock. Specifically, the applicant seeks to keep the previously permitted channelward floating dock on the ebbside of the pierhead. The work as described is for AFTER-THE-FACT authorization on a private, recreational dock.

This public notice is being distributed to all known interested persons and agencies to assist in developing facts on which a decision by the Department can be based. Comments concerning the proposed work must be submitted in writing, setting forth sufficient detail to furnish a clear understanding of the reasons for support or opposition.

Comments regarding this application must be received by the Department on or before **February 20, 2014**. For more information, please contact:  
**Steve Brooks at 843-953-0235 or via email at [brookss@dhec.sc.gov](mailto:brookss@dhec.sc.gov).**

**NOTE:** Plans depicting the proposed work are available and will be provided upon receipt of a written request or may be viewed on the Department website at [www.scdhec.gov/environment/ocrm/public\\_notice.htm](http://www.scdhec.gov/environment/ocrm/public_notice.htm).

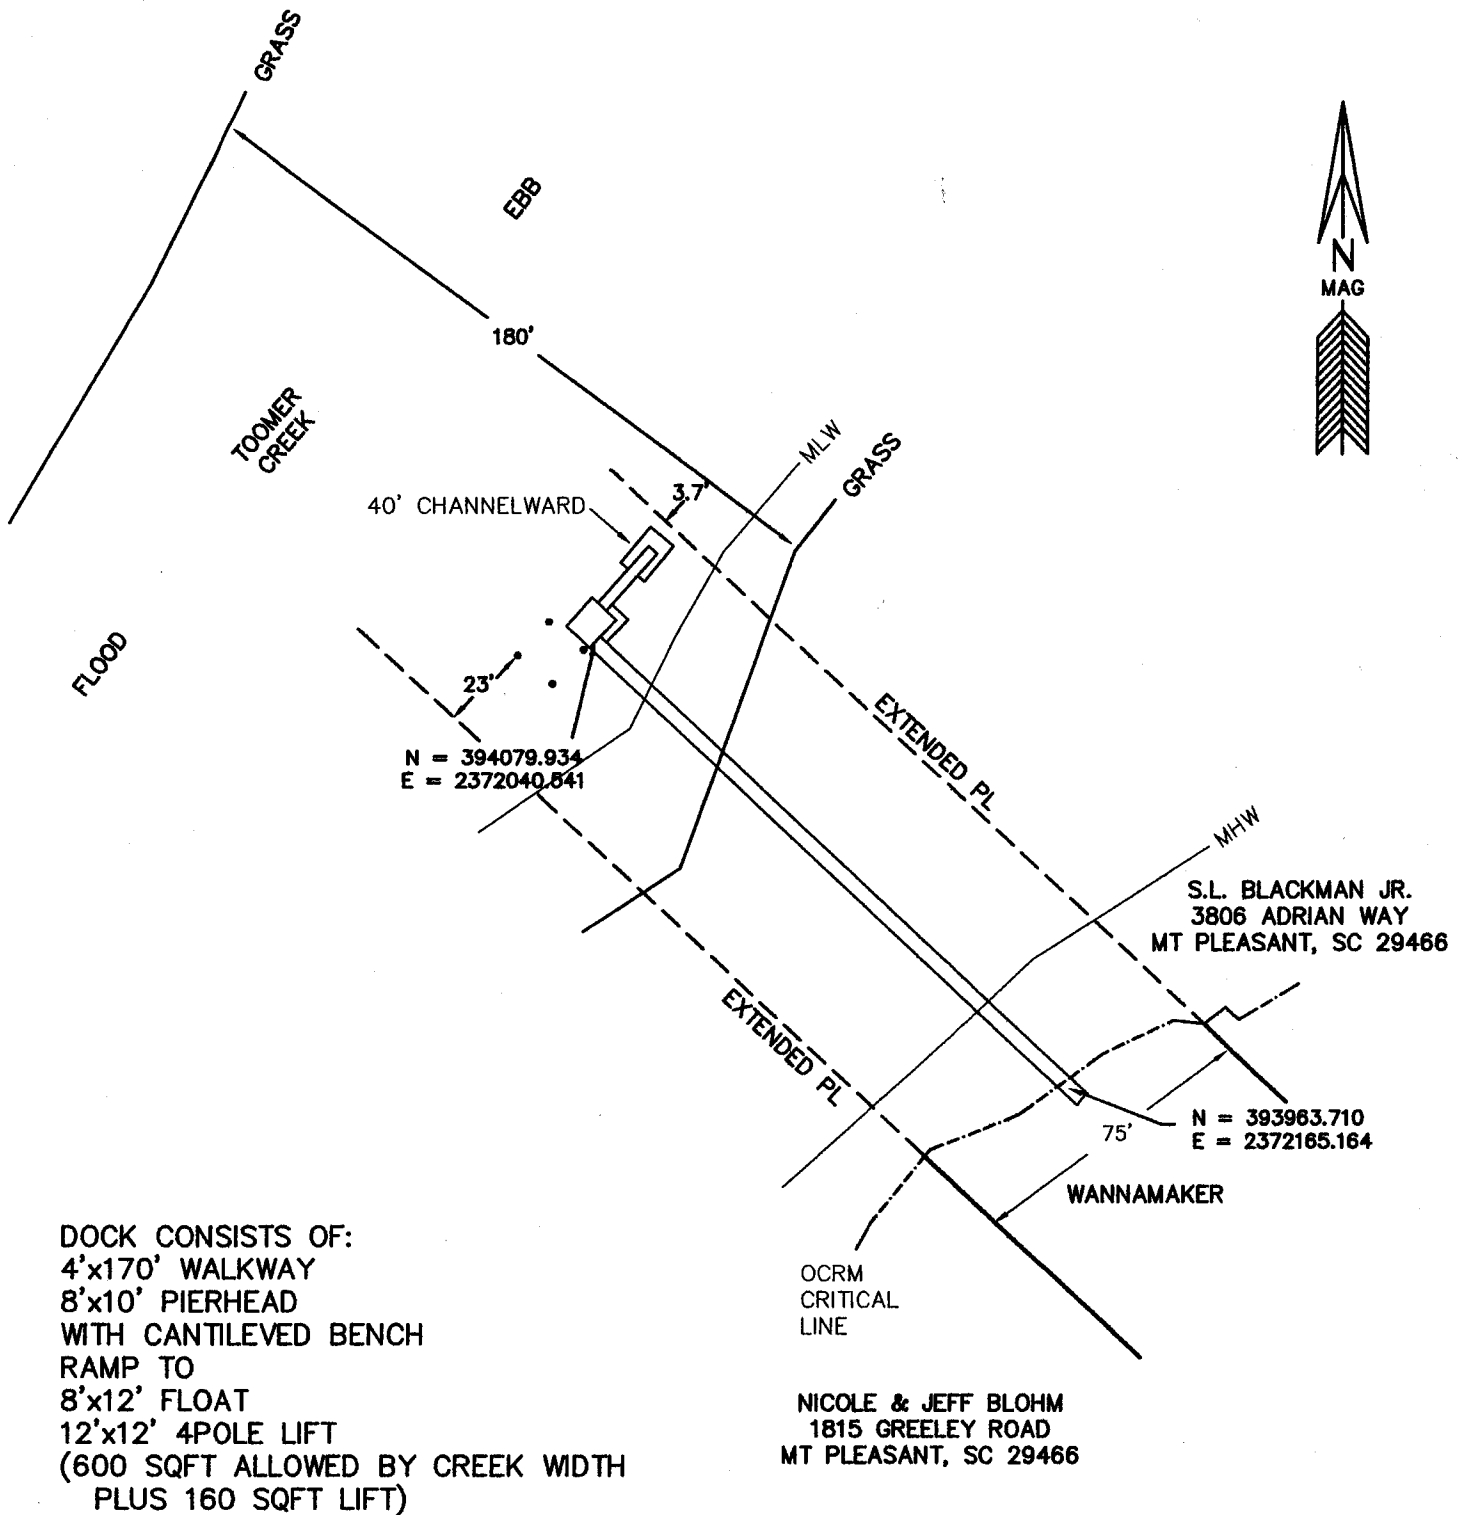


OCRM-14-024-B


APPLICANT: MARGARET WANNAMAKER  
3802 ADRIAN WAY  
MELROSE @ PARK WEST  
TOWN OF MOUNT PLEASANT  
CHARLESTON COUNTY  
TMS# 594-12-00-227  
TOOMER CREEK


ATF  
DOCK ASBUILT  
& AFTER THE FACT  
PERMIT

DATE: DECEMBER 3, 2013  
SCALE: 1" = 50'

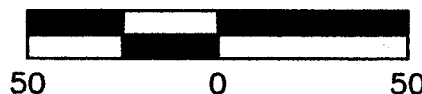

FILE #229-13

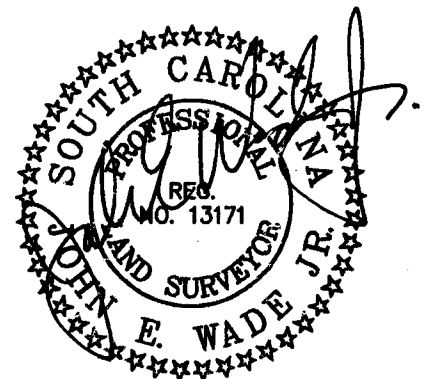

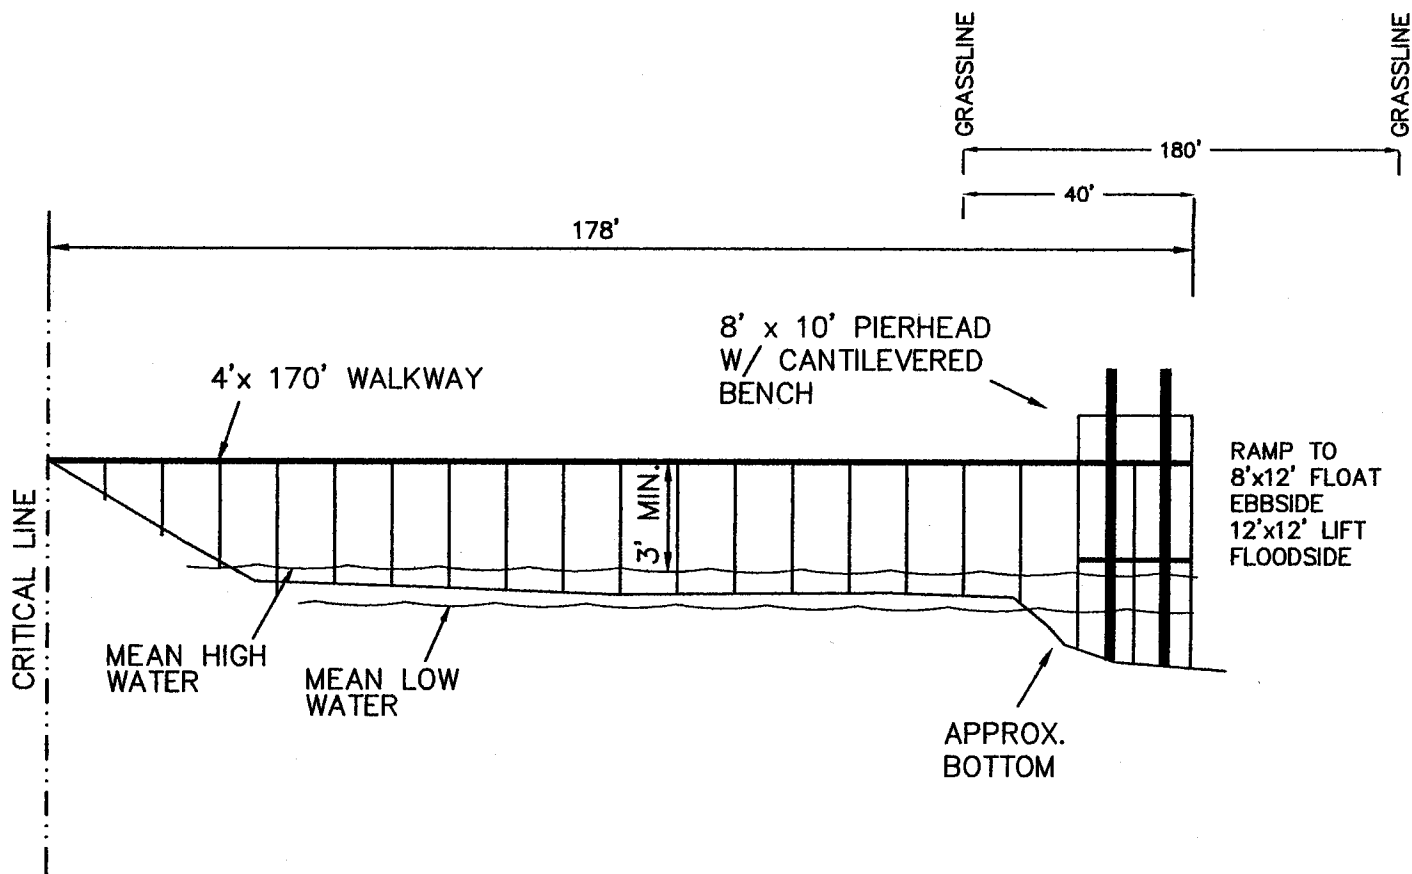


OCRM-14-024-B

APPLICANT: MARGARET WANNAMAKER  
 3802 ADRIAN WAY  
 MELROSE @ PARK WEST  
 TOWN OF MOUNT PLEASANT  
 CHARLESTON COUNTY  
 TMS# 594-12-00-227  
 TOOMER CREEK

ATF  
 DOCK ASBUILT  
 & AFTER THE FACT  
 PERMIT

DATE: DECEMBER 3, 2013  
 NO SCALE

FILE #229-13

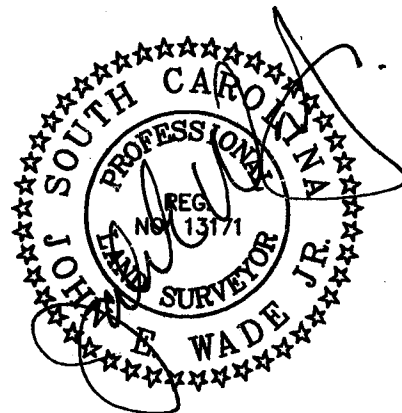




# Charleston County

Copyright 2004  
Charleston County GIS  
4045 Bridge View Drive  
North Charleston, SC 29405-7464

## Legend



Streets/Roads

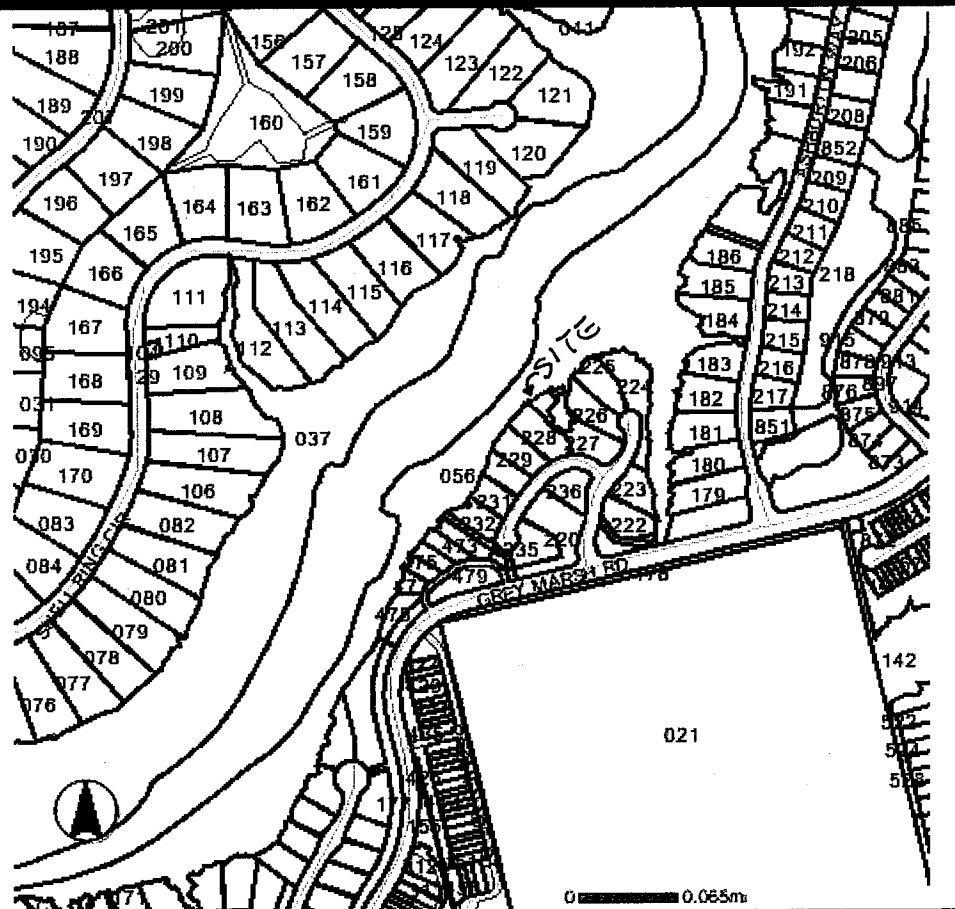

OCRM-14-024-B

APPLICANT: MARGARET WANNAMAKER  
3802 ADRIAN WAY  
MELROSE @ PARK WEST  
TOWN OF MOUNT PLEASANT  
CHARLESTON COUNTY  
TMS# 594-12-00-227  
TOOMER CREEK

ATF  
DOCK ASBUILT  
& AFTER THE FACT  
PERMIT

DATE: DECEMBER 3, 2013  
NO SCALE

FILE #229-13